THESE PLANS HAVE BEEN PREPARED FOR THE SAN BERNARDINO MUNICIPAL WATER DEPARTMENT (SRMWD). THESE PLANS ARE INTENDED TO SUPPLEMENT THE SRMWD'S WATER STANDARDS SPECIFICATIONS AND DRAWINGS.

2. ALL UTILITY LOCATIONS SHOWN ARE FROM RECORD INFORMATION ONLY AND ARE NOT A RESULT OF A FIELD SURVEY. CALL UNDERGROUND SERVICE ALERT AT 1-800-422-4133 - 48-HOURS

3. ALL WATER LINE CONNECTION POINTS AND CRITICAL UTILITY CROSSING POINTS SHALL BE EXPOSED AND ACCURATELY LOCATED AT THE START OF CONSTRUCTION, AND THE SBMWD SHALL BE

NOTIFIED OF ANY DISCREPANCIES PRIOR TO THE CONTINUATION OF WORK. ALL ELEVATIONS SHOWN ON PLANS SHALL BE BASED ON A U.S.G.S. DATUM, AND SHALL SHOW ELEVATION FROM MEAN SEA LEVEL

ALL HORIZONTAL OR VERTICAL CHANGES IN PIPE ALIGNMENT DELINEATED ON THE PLANS AS "DEFLECTION BY JOINT" OR SHOWN WITHOUT BENDS SHALL BE INSTALLED IN STRICT ACCORDANCE WITH MANUFACTURER'S RECOMMENDATIONS. TOTAL ANGULAR DISPLACEMENT SHALL BE DISTRIBUTED THROUGH AS MANY JOINTS AS PRACTICABLE.

ALL WORK SHALL BE IN ACCORDANCE WITH THE STANDARD SPECIFICATIONS FOR PUBLIC WORKS CONSTRUCTION (GREEN BOOK) - SBMWD WATER STANDARD SPECIFICATIONS. AND A.W.W.A. STANDARDS AND SPECIFICATIONS.

APPROVAL OF THIS PLAN BY THE SBMWD DOES NOT CONSTITUTE A REPRESENTATION AS TO THE ACCURACY OF THE LOCATION OR OF THE EXISTENCE OR NONEXISTENCE OF ANY UNDERGROUND UTILITY PIPE OR STRUCTURE WITHIN THE LIMITS OF THIS PROJECT. THE CONTRACTOR SHALL ASSUME FULL RESPONSIBILITY FOR THE PROTECTION OF ALL UTILITIES WITHIN THE LIMITS OF THE

DURING THE PERIOD OF CONSTRUCTION, THE CONTRACTOR SHALL FURNISH, ERECT AND MAINTAIN SUCH WARNINGS, SIGNS, STOP SIGNS, SIGNALS, BARRICADES AND OTHER SAFETY MEASURES AS DIRECTED BY THE CITY OF SAN BERNARDINO, DEVELOPMENT SERVICES DEPARTMENT WITH

THE CONTRACTOR SHALL NOT OPEN MORE TRENCHES THAN CAN BE PROPERLY PROSECUTED IN A DAY'S OPERATION. ANY TRENCH UNAVOIDABLY LEFT OPEN DURING THE HOURS OF DARKNESS OR OVER A WEEKEND SHALL BE FENCED WITH 6-FOOT CHAIN LINK AND PROPERLY LIGHTED. OR BRIDGED BY A SBMWD APPROVED TRAFFIC PLATE WITH REFERENCE TO THE W.A.T.C.H.

10. THE CONTRACTOR SHALL REINSTALL PAVEMENT MARKINGS AND STRIPING DISTURBED BY HIS

11. A CAL/OSHA PERMIT REQUIRED FOR TRENCHES OVER 5' IN DEPTH 12. THE CONTRACTOR SHALL PROVIDE SAFE AND CONTINUOUS PASSAGE FOR LOCAL PEDESTRIAN AND

VEHICULAR TRAFFIC AT ALL TIMES WITH REFERENCE TO THE W.A.T.C.H. MANUAL. 13. TRAFFIC SIGNAL FUNCTIONS SHALL BE THE RESPONSIBILITY OF THE CITY OF SAN BERNARDING, DEPARTMENT OF PUBLIC WORKS; HOWEVER THE CONTRACTOR IS REQUIRED TO GIVE 48 HOUR NOTICE PRIOR TO CONSTRUCTION THAT WILL DAMAGE OR AFFECT ANY BURIED TRAFFIC

14. THE CONTRACTOR SHALL SO CONDUCT HIS OPERATIONS AS TO OFFER THE LEAST POSSIBLE OBSTRUCTION AND INCONVENIENCE TO THE PUBLIC AND HE SHALL HAVE UNDER CONSTRUCTION NO GREATER LENGTH OR AMOUNT OF WORK THAN HE CAN PROSECUTE PROPERLY WITH DUE REGARD TO THE RIGHTS OF THE PUBLIC. CONVENIENT ACCESS TO DRIVEWAYS. HOUSES AND BUILDINGS ALONG THE LINE OF WORK SHALL BE MAINTAINED. TEMPORARY CROSSINGS SHALL BE PROVIDED AND MAINTAINED IN GOOD CONDITION. NOT MORE THAN ONE CROSSING OR INTERSECTING STREET OR ROAD SHALL BE CLOSED AT ANY ONE TIME WITHOUT THE APPROVAL O THE CITY OF SAN BERNDARINO DEVELOPMENT SERVICES DEPARTMENT. THE CONTRACTOR SHALL PROVIDE AND MAINTAIN SUCH FENCES, BARRIERS, DIRECTIONAL SIGNS, LIGHTS, AND FLAG MEN AS ARE NECESSARY TO GIVE ADEQUATE WARNING TO THE PUBLIC AT ALL TIMES OF ANY DANGEROUS CONDITIONS TO BE ENCOUNTERED AS A RESULT OF THE CONSTRUCTION WORK AND TO GIVE DIRECTIONS TO THE PUBLIC.

15. STREET CUT PERMITS MUST BE OBTAINED FROM THE CITY OF SAN BERNARDINO DEVELOPMENT

16. ALL REMOVALS IN PAVED AREAS SHALL BE SAW CUT ON A NEAT STRAIGHT LINE PARALLEL TO THE PIPE LINE. THE CUT EDGE SHALL BE PROTECTED FROM CRUSHING AND ALL BROKEN EDGES

SHALL BE RE-CUT PRIOR TO PAVING OPERATIONS. 17. DUST SHALL BE CONTROLLED AT ALL TIMES BY APPROVED METHODS.

18. PUBLIC STREETS SHALL BE KEPT CLEAN AND FREE FROM DIRT AND/OR DEBRIS. THE CONTRACTOR SHALL BE RESPONSIBLE FOR ALL COSTS INCURRED IN STREET CLEANING NECESSITATED BY HIS OPERATION.

19. ALL TRENCH BACK FILL SHALL BE TESTED AND CERTIFIED BY A SOILS ENGINEER PRIOR

BE MADE BY CALLING (909) 384-5391 BETWEEN 7:00 A.M. AND 4:30 P.M. WEEKDAYS.

21. NORMAL INSPECTION HOURS ARE 7:30 A.M. TO 4:00 P.M. MONDAY THROUGH FRIDAY EXCEPT LEGAL HOLIDAYS. REQUESTS FOR INSPECTION AT OTHER TIMES OR ON OTHER DAYS MUST BE SUBMITTED TO THE SBMWD ENGINEERING SECTION A MINIMUM OF 5 WORKING DAYS BEFORE THE INSPECTION IS REQUIRED. THE CONTRACTOR MUST BEAR THE COST OF SUCH OVERTIME INSPECTIONS AND WILL BE BILLED ACCORDINGLY NORMAL OVERTIME RATES ARE 1.5 TIMES THE BASE RATE PLUS OVERHEAD. OVERTIME INSPECTIONS WILL BE MADE SOLELY AT THE

DISCRETION OF THE SBMWD AND BASED ON STAFF AVAILABILITY. THE CONTRACTORS WILL BE REQUIRED TO OBTAIN CITY BUSINESS LICENSES. INSURANCE AND

PROVIDE EVIDENCE OF SAME TO INSPECTION STAFF UPON REQUEST. 23. THE CONTRACTOR SHALL NOT PLACE CONCRETE OR ASPHALT ON THE PROJECT PRIOR TO SBMWD

REVIEW APPROVAL OF CONTRACTOR- SUPPLIED COMPACTION TESTS. NO DEVIATIONS SHALL BE MADE FROM THIS PLAN WITHOUT THE REVIEW AND APPROVAL OF THE

THE CONTRACTOR SHALL NOT MAKE ANY CONNECTION TO THE EXISTING SBMWD DISTRIBUTION SYSTEM WITHOUT FIRST GAINING WRITTEN PERMISSION TO DO SO FROM THE WATER DEPARTMENT ENGINEER. IN THE EVENT THAT PERMISSION IS GRANTED, A SBMWD INSPECTOR MUST BE PRESENT ON SITE TO WITNESS SAID CONNECTION(S). TEST PLATES SHALL BE INSTALLED ON THE

AND TESTING SHALL BE PERFORMED EITHER BY (A) WATER TRUCK, OR (B) HYDRANT-TO-HYDRANT CONNECTION THROUGH AN APPROVED BACK FLOW PREVENTION ASSEMBLY. ALL WATER MAINS AND APPURTENANCES SHALL PRESSURE TESTED AND DISINFECTED PRIOR TO ACCEPTANCE BY THE SBMWD.

NEW CONSTRUCTED SIDE OF ALL MAIN CONNECTION POINTS. ALL FLUSHING, CHLORINATION,

TESTING AND DISINFECTION OF WATER MAINS AND APPURTENANCES SHALL BE IN ACCORDANCE WITH THE APPLICABLE A.W.W.A. STANDARDS EXCEPT AS HEREIN MODIFIED. (SEE SBMWD WATER STANDARD SPECIFICATIONS)

ALL TESTING AND DISINFECTION SHALL BE MADE IN THE PRESENCE OF THE SBMWD INSPECTOR. THE CONTRACTOR SHALL NOTIFY THE ENGINEER NOT LESS THAN TWENTY-FOUR (24) HOURS IN ADVANCE OF THE ACTUAL TIME OF TESTING AND/OR DISINFECTION SO THAT THE ENGINEER OR DESIGNEE MAY OBSERVE THE PROCEDURE.

29. IF THE PRESSURE TEST, CHLORINATION OR BACTERIOLOGICAL TEST FAIL TO MEET THE REQUIREMENT OF THE SPECIFICATIONS, THE CONTRACTOR SHALL MAKE NECESSARY REPAIRS,

REPLACEMENTS OR REPETITION OF PROCEDURES AT HIS OWN EXPENSE 30. AT DEAD END LOCATIONS, WATER SERVICE SHALL BE TAPPED TO THE END OF WATER MAIN.

## **ENGINEER'S NOTICE TO CONTRACTOR:**

CONTRACTOR AGREES THAT HE SHALL ASSUME SOLE AND COMPLETE RESPONSIBILITY FOR JOB SITE CONDITIONS DURING THE COURSE OF CONSTRUCTION, INCLUDING SAFETY OF AL PERSONS AND PROPERTY. THIS REQUIREMENT SHALL APPLY CONTINUOUSLY AND NOT BE LIMITED TO NORMAL WORKING HOURS. THE CONTRACTOR SHALL DEFEND, INDEMNIFY AND HOLD THE OWNER AND ENGINEER HARMLESS FROM ANY AND ALL LIABILITY, ALLEGED, IN CONNECTION WITH THE PERFORMANCE OF WORK ON THIS PROJECT EXCEPTING

FOR LIABILITY ARISING FROM THE SOLE NEGLIGENCE OF THE OWNER OR ENGINEER. ALL UNDERGROUND UTILITIES OR STRUCTURES, REPORTED OR FOUND ON PUBLIC RECORDS ARE INDICATED WITH THEIR APPROXIMATE LOCATION AND EXTENT. THE OWNER. BY ACCEPTING THESE PLANS OR PROCEEDING WITH THE IMPROVEMENTS HEREON, AGREES TO ASSUME LIABILITY AND TO HOLD THE ENGINEER HARMLESS FOR ANY DAMAGES RESULTING FROM THE EXISTENCE OF UNDERGROUND UTILITIES OR STRUCTURES NOT REPORTED OR INDICATED ON PUBLIC RECORDS, OR THOSE CONSTRUCTED AT VARIANCE WITH REPORTED OR RECORDED LOCATIONS. THE CONTRACTOR IS REQUIRED TO TAKE DUE PRECAUTIONARY MEASURES TO PROTECT THE UTILITIES OR STRUCTURES SHOWN AND ANY OTHERS FOUND AT IT SHALL BE THE CONTRACTOR'S RESPONSIBILITY TO NOTIFY THE OWNERS OF ALL UTILITIES OR STRUCTURES CONCERNED BEFORE STARTING WORK.

THE ENGINEER PREPARING THESE PLANS WILL NOT BE RESPONSIBLE FOR, OR LIABLE FOR UNAUTHORIZED CHANGES TO OR USES OF THESE PLANS. ALL CHANGES TO THE PLANS MUST BE IN WRITING AND MUST BE APPROVED BY THE PREPARER OF THESE PLANS.

4. THE ENGINEER DOES NOT RECOMMEND OR ENDORSE THE USE OF ASBESTOS-CEMENT WATER PIPE OR ANY PRODUCTS CONTAINING ASBESTOS DUE TO THE HEALTH HAZARD CONNECTED WITH SUCH PRODUCTS. SPECIFICATION HEREON OF ANY SUCH PRODUCT IS AT THE DIRECTION OF THE JURISDICTIONAL AGENCY. THE CONTRACTOR SHALL ASSUME RESPONSIBILITY FOR ALL CONSTRUCTION, CONNECTION AND REMOVAL OF ASBESTOS PRODUCTS AND SHALL FOLLOW ALL

AND E.P.A. GUIDELINES TO MINIMIZE HEALTH HAZARDS. IT SHALL BE THE RESPONSIBILITY OF THE CONTRACTOR TO VERIFY ALL DIMENSIONS AND CONDITIONS SHOWN HEREON AT THE JOB SITE PRIOR TO ANY CONSTRUCTION. FUSCOE ENGINEERING, INC. SHALL BE NOTIFIED OF ANY DISCREPANCIES. REVISIONS TO THE PLAN SHALL BE APPROVED BY THE ENGINEER IN WRITING PRIOR TO IMPLEMENTATION. SAN BERNARDINO MUNICIPAL WATER DEPARTMENT TRACT NO. 14254

29

23 4

LEGEND:

WATER IMPROVEMENT PLANS WATER DEPARTMENT'S ENGINEER CERTIFICATE THIS CERTIFIES THAT ON OCCUBER 6 THE PLAN OF THE DOMESTIC WATER SYSTEM FOR TRACT 14254, AND FIND THAT IT MEETS THE MINIMUM REQUIREMENTS OF THE CALIFORNIA HEALTH AND SAFETY CODE AND CALIFORNIA WATER CODE FOR THE DESIGN AND CONSTRUCTION OF DOMESTIC WATER SYSTEMS. 'IRRIGATION 45 SERVICE PRINCIPAL ENGINEER 46 CALIFORNIA R.C.E. NO. 58079 EXPIRATION DATE: 6/30/2006 NOTE: PRIOR TO ANY WATER DISCHARGE THE CONTRACTOR SHALL NOTIFY SBMWD WATER QUALITY AT (909) 384-5139 42 FIVE DAYS IN ADVANCE OF THE INTENDED DISCHARGE, OR DEVELOPER PROP. 6" WET BARREL PROP. 6" WEY BARREL

33

PROP. 6" WET BARREL

FIRE HYDRANT (1-4" & 1-2 1/2")

PROP. 8"

63

66

34

**62** 

35

PROP.

61

68

FIRE HYDRANT (1-4" & 1-2 1/2")

37

36

60

59

58

71

PROP. 6" WET BARREL

(1-4" & 1-2 1/2")

FIRE HYDRANT

PROP. 8

DIP MAIN

RELOCATED 2"
IRRIGATION METER PER

1-WAY WET

1-WAY WET

NDEX MAP

SCALE: 1"=80'

DRAWN BY:

BARREL W/ST.

NOZ. (LONG BEACH)


BARREL W/ ST. NOZ. (LONG BEACH) W/ 6° GV

FIELD CONDITIONS

PROP. 8'

57

31

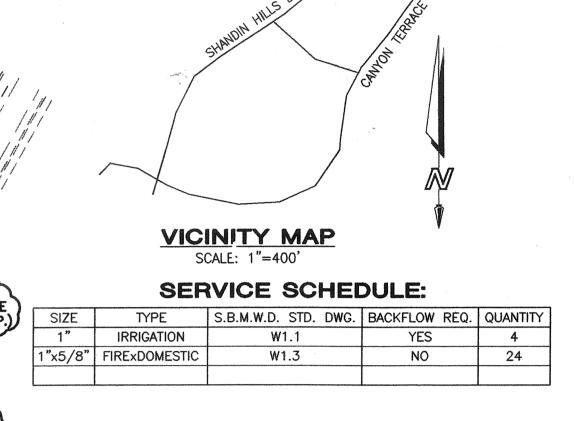

SYCAMORE PRESSURE ZONE (1580')

-- MOUNTAIN DRIVE

MATERIALS LIST AND QUANTITIES:

1-WAY WET

BARREL W/ ST.

					4	NC	DTE:			
.N.	SIZE	DESCRIPTION	CONFIGURATION	QUANTITY	QUANTITIES ARE APPROXIMATED. ACTUAL QUANTITIES MAY			S MAY VARY		
1)	8".	AWWA C151 CML D.I.P.	TJ	3,197 LF		C.N.	SIZE	DESCRIPTION	CONFIGURATION	QUANTITY
2)	6"	AWWA C151 CML D.I.P.	TJ	63 LF		15)	8"	11 1/4° BEND CML D.I.P.	MJ × MJ	1 EA
3	6"	AWWA C503-82 F.H. W/BURY	1-4" & 1-2-1/2"	9 EA		16	6"	MJ RESTRAINT	MEGA-LUG	18 EA
6)	1"	BACKFLOW ASSEMBLY	S.B.M.W.D. STD. W4.1	4 EA		16	8"	MJ RESTRAINT	MEGA-LUG	46 EA
カ	1"	AIR VACUUM RELEASE VALVE	S.B.M.W.D. STD. W7.3	6 EA		16	8"	FIELD-LOK	·	65 EA
8)	12"x12"x8"	TAPPING SLEEVE FOR 12" D.I.P.	EPOXY COATED STD. W3.5	2 EA		17	STD.	BLUE DOT PVMT. MARKER	S.B.M.W.D. STD. W6.3	13 EA
9	8"x8"x8"	TEE CML D.I.P.	FL x FL x FL	4 EA		18	1"	AIR VACUUM RELEASE VALVE	S.B.M.W.D. STD. W7.1	1 EA
0	8"x8"x6"	TEE CML D.I.P.	MJ x MJ x FL	9 EA		19	8"	ADAPTER	FL x MJ	6 EA
1	8"	G.V. W/CAN AWWA C509	FL x MJ	8 EA		20	8"	D.I.P. CAP W/ 1" THRD. OUTLET	MJ	4 EA
3	6"	G.V. W/CAN AWWA C509	FL × MJ	9 EA		2)	8"	HOT TAP CML D.I.P.	S.B.M.W.D. STD. W3.7	2 EA
3	8"	45° BEND CML D.I.P.	MJ × MJ	2 EA		22	8"	G.V. W/CAN AWWA C509	FL x FL	2 EA
_		22 1/2° BEND	MJ x MJ		1/			FNOACENEUT	-	

## FIRE HYDRANT

PROPOSED GATE VALVE

PROPOSED WATER LINE

CHLORINATION AND FLUSHING PORT

MECHANICAL JOINT (MJ) BEND

PIPE CROSSING OVER EXISTING

PIPE CROSSING UNDER EXISTING

AIR VACUUM AND/OR AIR RELEASE VALVE

HORIZONTAL DEFLECTION BY JOINT

EXISTING WATER LINE

EXISTING VALVE

RESTRAINT JOINT

THRUST BLOCK

PROP. 67 WET BARREL

(1-4"/&/1-2 1/2")

) INSTALL 8" PRESSURE CLASS 350 CEMENT MORTAR LINED DUCTILE IRON PIPE PER S.B.M.W.D. STANDARD SPECIFICATIONS INSTALL 6" PRESSURE CLASS 350 CEMENT MORTAR LINED DUCTILE IRON PIPE PER S.B.M.W.D. STANDARD SPECIFICATIONS INSTALL 6" FIRE HYDRANT ASSEMBLY PER S.B.M.W.D. STD. DWG. NO. W2.2 (CONFIG. A)

PROP. 6" WET BARREL

(1-4" & 1-2 1/2")

) INSTALL COMBINATION 5/8" DOMESTIC WATER SERVICE AND 1" FIRE SERVICE PER PER S.B.M.W.D. STD. DWG. NO. W1.3 INSTALL 1" IRRIGATION WATER SERVICE PER S.B.M.W.D. STD. DWG. NO. W1.1

INSTALL 1" REDUCED PRESSURE PRINCIPLE BACKFLOW PREVENTION ASSEMBLY PER S.B.M.W.D. STD. DWG. NO. W4.1

) INSTALL 1" AIR RELEASE VALVE PER S.B.M.W.D. STD. DWG. NO. W7.3 ) INSTALL 12"x8" EPOXY COATED TAPPING SLEEVE FOR 8" DIP PER S.B.M.W.D. STD. DWG. NO. 3.5

MAY PROVIDE EVIDENCE OF A DISCHARGE

DAYLIGHT LINE

IRRIGATION

SERVICE

PERMIT OR SWPPP.

1" IRRIGATION

INSTALL 8" FL X 8" FL X 8" FL DUCTILE IRON TEE O) INSTALL 8" MJ X 8" MJ X 6" FL DUCTILE IRON TEE

) INSTALL 8" FL X MJ GATE VALVE PER S.B.M.W.D. STD. DWG. NO. W3.1 2) INSTALL 6" FL X MJ GATE VALVE PER S.B.M.W.D. STD. DWG. NO. W3.1 13) INSTALL 8" MJ X MJ DUCTILE IRON 45" BEND

**CONSTRUCTION NOTES:** 

4) INSTALL 8" MJ X MJ DUCTILE IRON 22 1/2" BEND 5) INSTALL 8" MJ X MJ DUCTILE IRON 11 1/4" BEND

(16) INSTALL LINEAR JOINT RESTRAINT PER MANUFACTURER'S SPECIFICATIONS & S.B.M.W.D. STD. DWG. NO. W6.4 ON ALL JOINTS

WITHIN MINIMUM LENGTH SPECIFIED ON PLAN. SEE JOINT RESTRAINT NOTE HEREON (17) INSTALL BLUE DOT PAVEMENT MARKER PER S.B.M.W.D. STD. DWG. NO. W6.3 (18) INSTALL 1" AIR RELEASE VALVE PER S.B.M.W.D. STD. DWG. NO. W7.1

19) INSTALL 8" FL X MJ ADAPTER

BENCH MARK:

ELEVATION = 1340.348

BRASS DISK, 50.0 FT SOUTH

AND 30.6 FT EAST OF THE CENTERLINE P.I. OF 40TH AND NORTH "E" STREET; IN THE TOP OF THE 4" P.C.C. CURBING AT THE INTERSECTION OF THE PAGE OF THE STREET; APOUT

BACK OF THE SIDEWALKS: ABOU

0.4 FEET ABOVE THE WALK.

) INSTALL 8" END CAP W/8" MEGALUG AND 1" THREADED OUTLET FOR SERVICE ) HOT TAP 12" EXIST. MAIN PER S.B.M.W.D. STD. DWG. NO. W3.7

PROPOSED BUTTERFLY VALVE 2) INSTALL 8" FL X FL GATE VALVE PER S.B.M.W.D. STD. DWG. NO. W3.1
3) INSTALL STRUCTURAL SUPPORT AT CROSSING PER S.B.M.W.D. STD. DWG. NO. W5.2 **WATER METER NOTE:** CONTRACTOR TO LOCATE SERVICE LATERALS AND WATER METERS. JOINT RESTRAINT DENOTES W.S. CHANGED TO SINGLE DOMESTIC SERVICE 

**QUANTITY NOTES:** 

QUANTITIES ARE FOR PLAN CHECK AND BONDING PURPOSES ONLY. 2. CONTRACTOR IS RESPONSIBLE FOR CALCULATING OWN QUANTITIES.

DECLARATION OF RESPONSIBLE CHARGE: ENGINEER OF WORKS I HEARBY DECLARE THAT I AM THE ENGINEER OF WORK FOR THIS PROJECT.

THAT I HAVE EXCERCISED RESPONSIBLE CHARGE OVER DESIGN OF THIS PROJECT AS DEFINED IN SECTION 6703 OF THE BUSINESS AND PROFESSIONS CODE, AND THAT HEALTH AND SAFETY CODE AND CALIFORNIA WATER CODE FOR THE THE DESIGN IS CONSISTENT WITH CURRENT STANDARDS.

UNDERSTAND THAT THE CHECK OF PROJECT DRAWINGS AND SPECIFICATIONS BY THE SAN BERNARDINO MUNICIPAL WATER DEPARTMENT IS CONFINED TO A REVIEW ONLY AND DOES NOT RELIEVE ME, AS ENGINEER OF WORK, OF MY RESPONSIBILITES FOR A PROJECT DESIGN

CALIFORNIA R.C.E. NO. 047255 EXPIRATION DATE: 12/31/05

ASSESSOR PARCEL NO. 266-211-30

SHEET INDEX: SHADY CREEK GLENWOOD COURT & HURD CREEK WAY \_\_\_ SHT. 3 AMBERWOOD & MULE CREEK COURTS \_\_\_\_\_ SHT. 4

> CITY OF SAN BERNARDINO WATER DEPARTMENT AS - BUILT

10-6-05

DIAL TOLL FREE

1-800-227-2600 AT LEAST TWO DAYS

BEFORE YOU DIG UNDERGROUND SERVICE ALERT

OF SOUTHERN CALIFORNIA

MUNICIPAL WATER DEPARTMENT W.O. 22176

TITLE SHEET

SHOWN ON THESE PLANS ARE OBTAINED BY A SEARCH OF THE AVAILABLE RECORDS. TO THE BEST OF OUR KNOWLEDGE THERE ARE NO EXISTING UTILITIES EXCEPT AS SHOWN ON THESE PLANS. THE CONTRACTOR IS REQUIRED TO TAKE DUE PRECAUTIONARY MEASURES TO PROTECT UTILITY LINES SHOWN ON THESE DRAWINGS. THE CONTRACTOR IS REQUIRED TO TAKE DUE PRECAUTIONARY MEASURES TO PROTECT UTILITY LINES SHOWN ON THESE DRAWINGS. THE CONTRACTOR TO THE RESULTED SHOWN ON THE SHOWN ON THE SHOWN ON THE SHOWN ON THE SHOWN OF THE SHOWN ON THE S RESPONSIBILITY FOR THE UTILITY PIPES, CONDUITS, OR STRUCTURE SHOWN OR NOT SHOWN ON THESE DRAWINGS. CONTRACTOR AGREES THAT HE SHALL ASSUME SOLE AND COMPLETE RESPONSIBILITY FOR JOB SITE CONDITIONS DURING THE COURSE OF CONSTRUCTION OF THIS PROJECT, INCLUDING SAFETY OF ALL PERSONS AND PROPERTY, THAT THIS REQUIREMENT SHALL APPLY CONTINUOUSLY AND NOT BE LIMITED TO NORMAL WORKING HOURS, AND THAT THE CONTRACTOR SHALL DEFEND, INDEMNIFY AND HOLD THE COUNTY THE OWNER AND THE ENGINEER HARMLESS FROM ANY AND ALL LIABILITY, REAL OR ALLEGED, IN CONNECTION WITH THE PERFORMANCE OF WORK ON THIS PROJECT. EXCEPTING FOR LIABILITY ARISING FROM THE SOLE

THE EXISTENCE AND LOCATION OF ANY UNDERGROUND UTILITY PIPES, CONDUITS OR

NEGLIGENCE OF THE OWNER OR THE ENGINEER.

ENGINEERING 10390 Commerce Center Drive, Suite 200

Rancho Cucamonga, California 91730

tel 909.581.0676 • fax 909.581.0696

www.fuscoe.com



AS-BUILT PER FIELD CONDITIONS

DESCRIPTION

CHECKED BY:

JOINT RESTRAINT NOTES:

. USE MEGA-LUGS FOR JOINT RESTRAINT AT FITTINGS.

2. USE FIELD-LOK GASKETS FOR JOINT RESTRAINT AT PIPE JOINTS.


S.B.M.W.D. CITY FIRE DEPARTMENT DATE:


NO EXCEPTIONS NOTED


WATER IMPROVEMENT PLANS **TRACT NO. 14254** 


CITY OF SAN BERNARDINO


SHEET 1 5 SHEETS

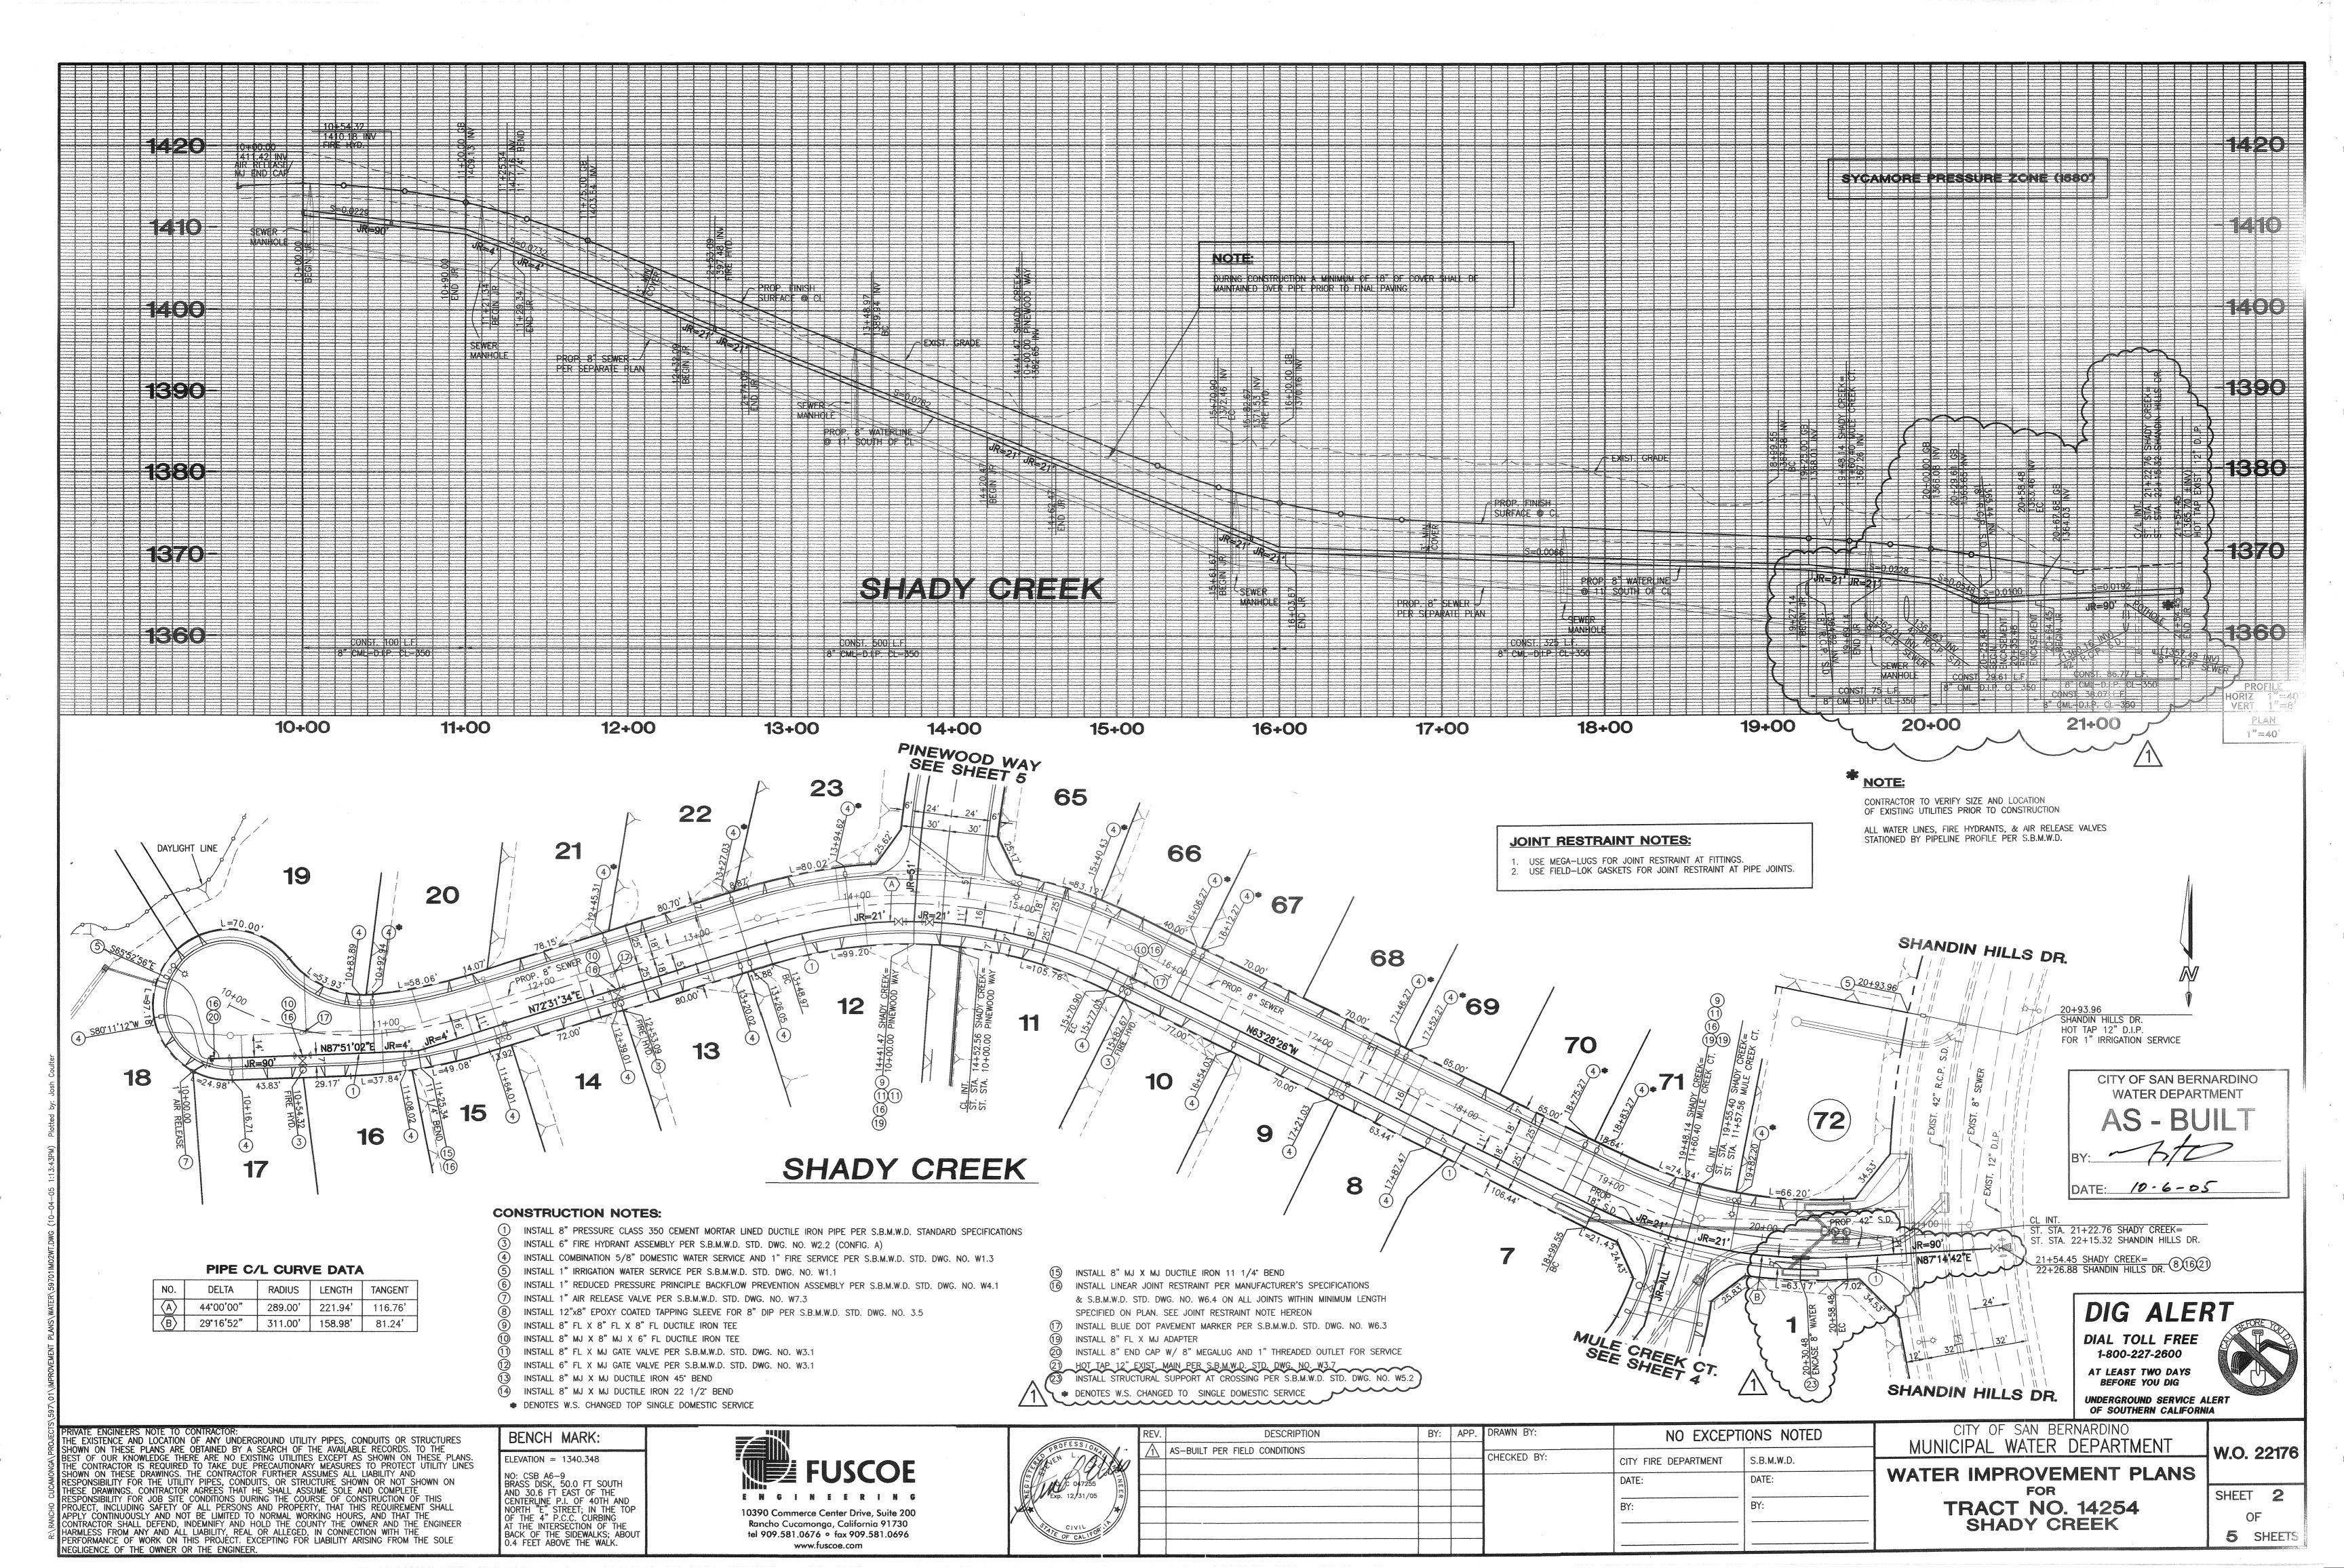

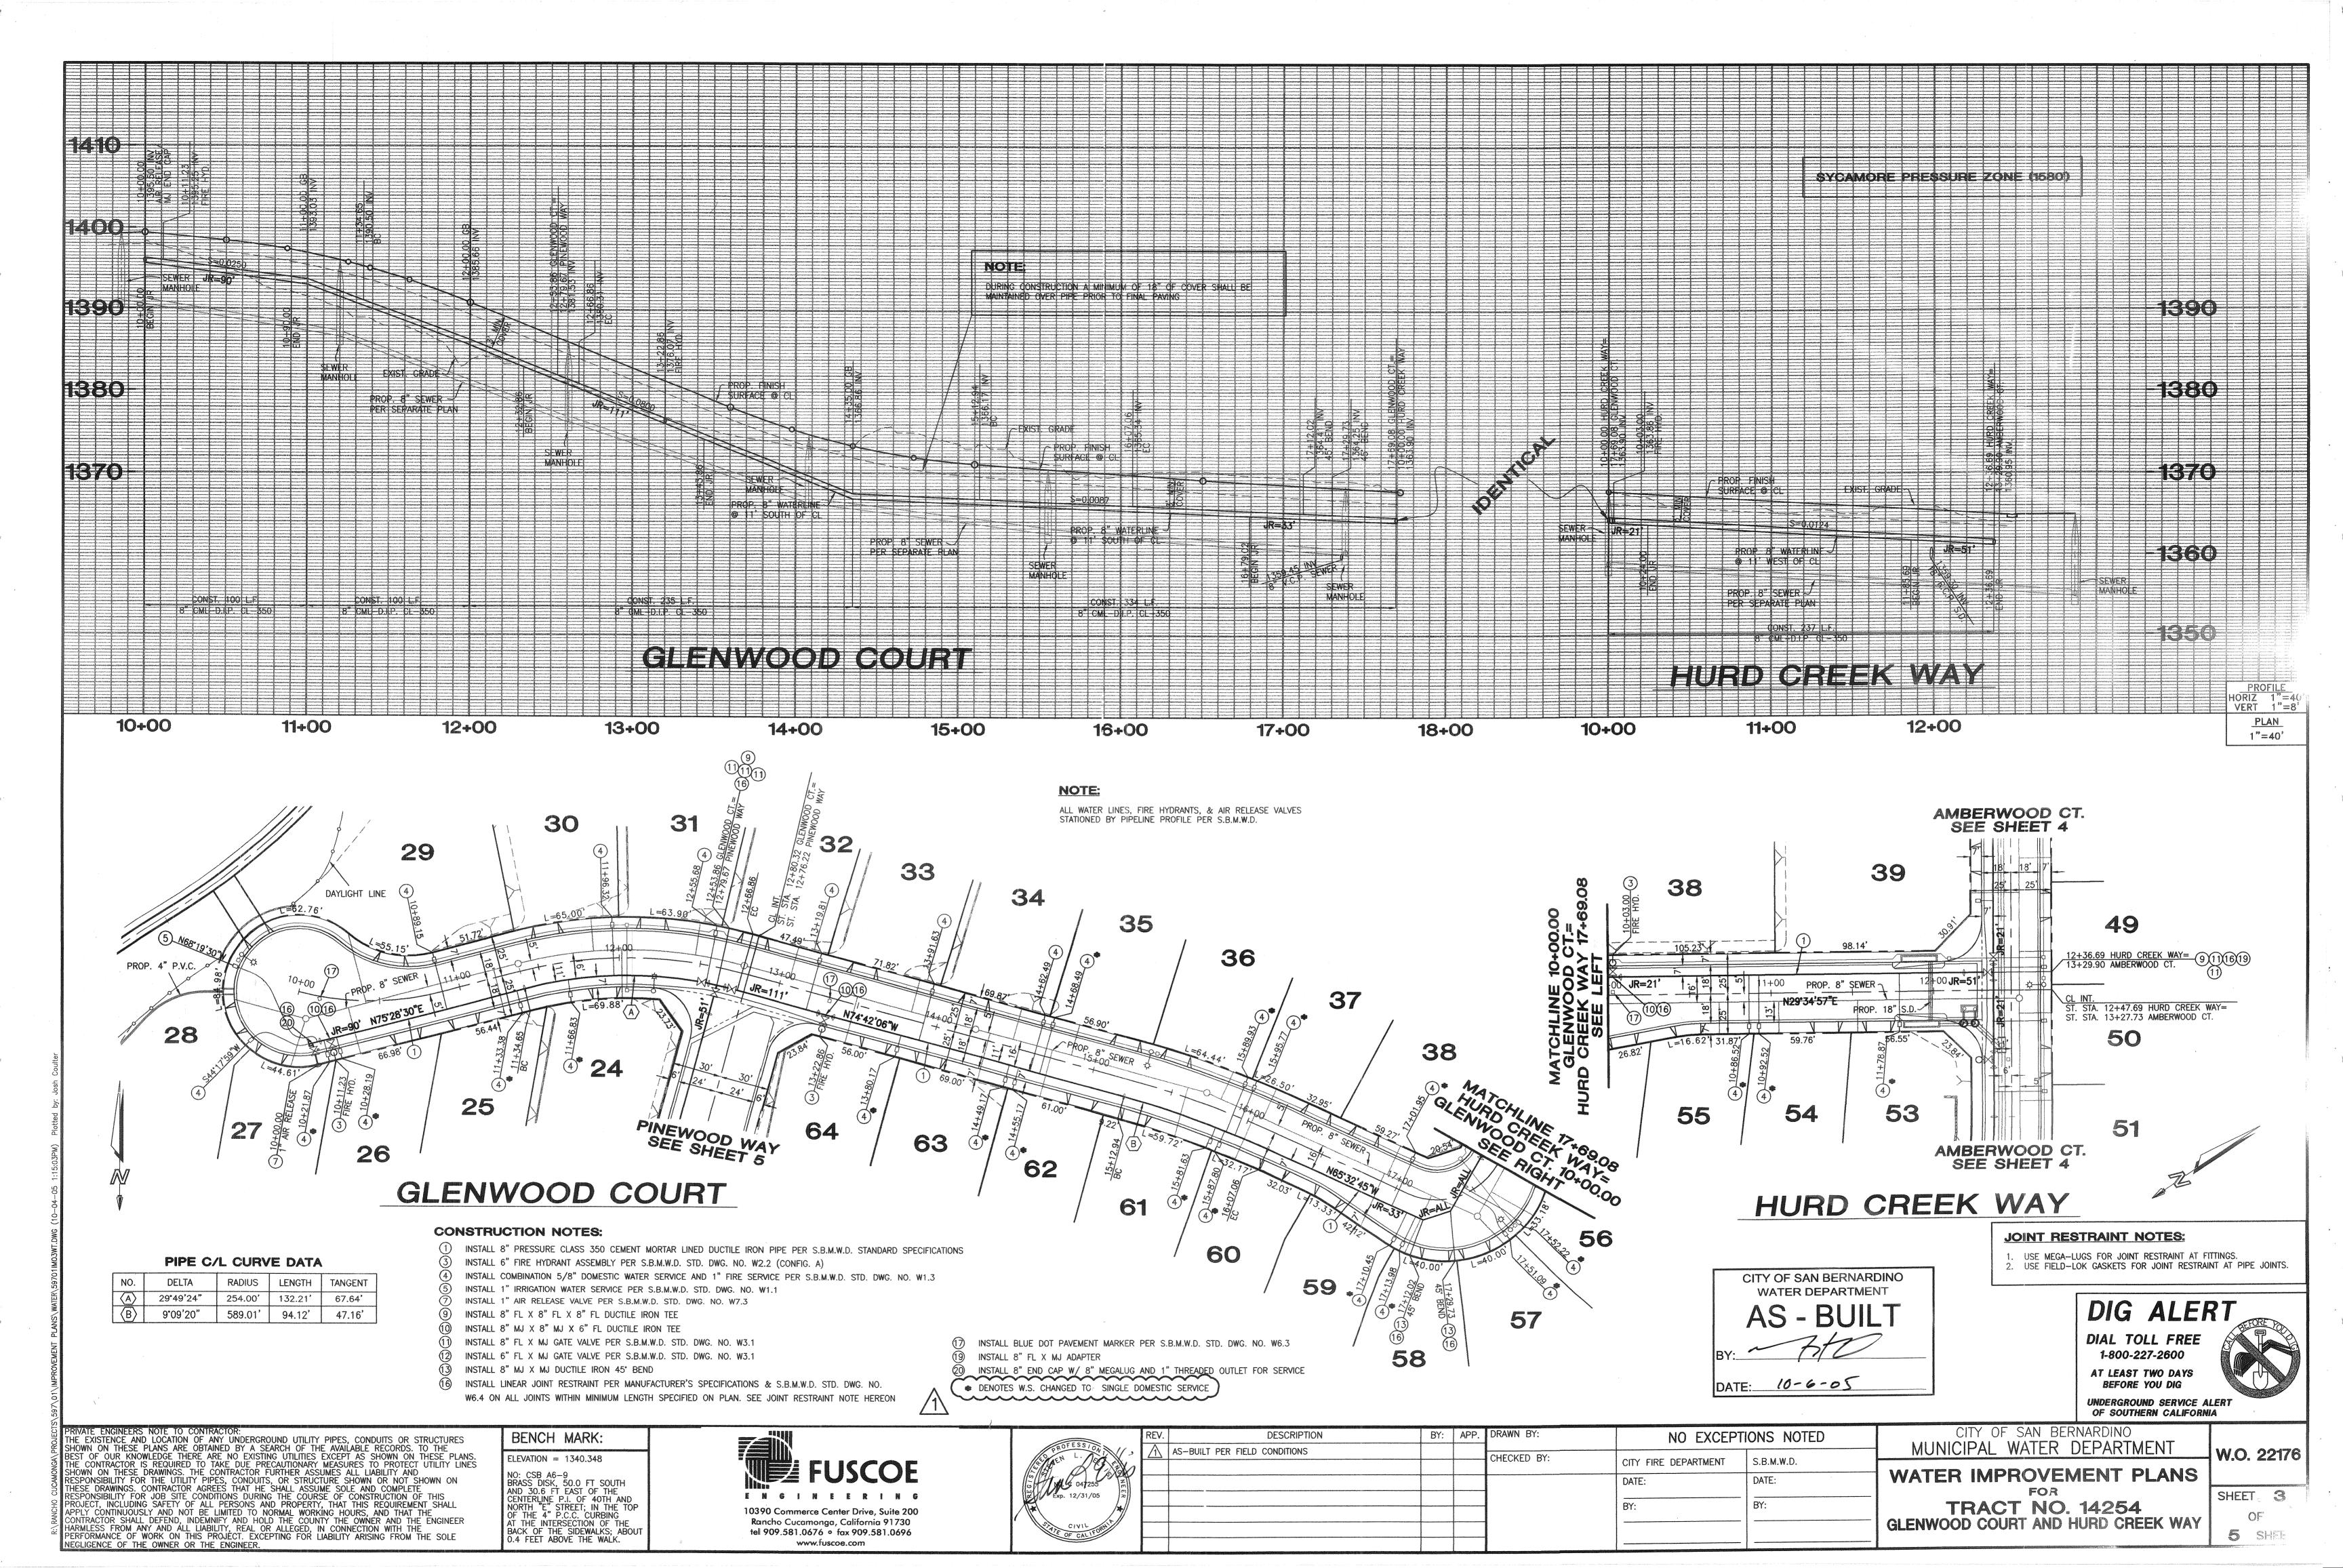

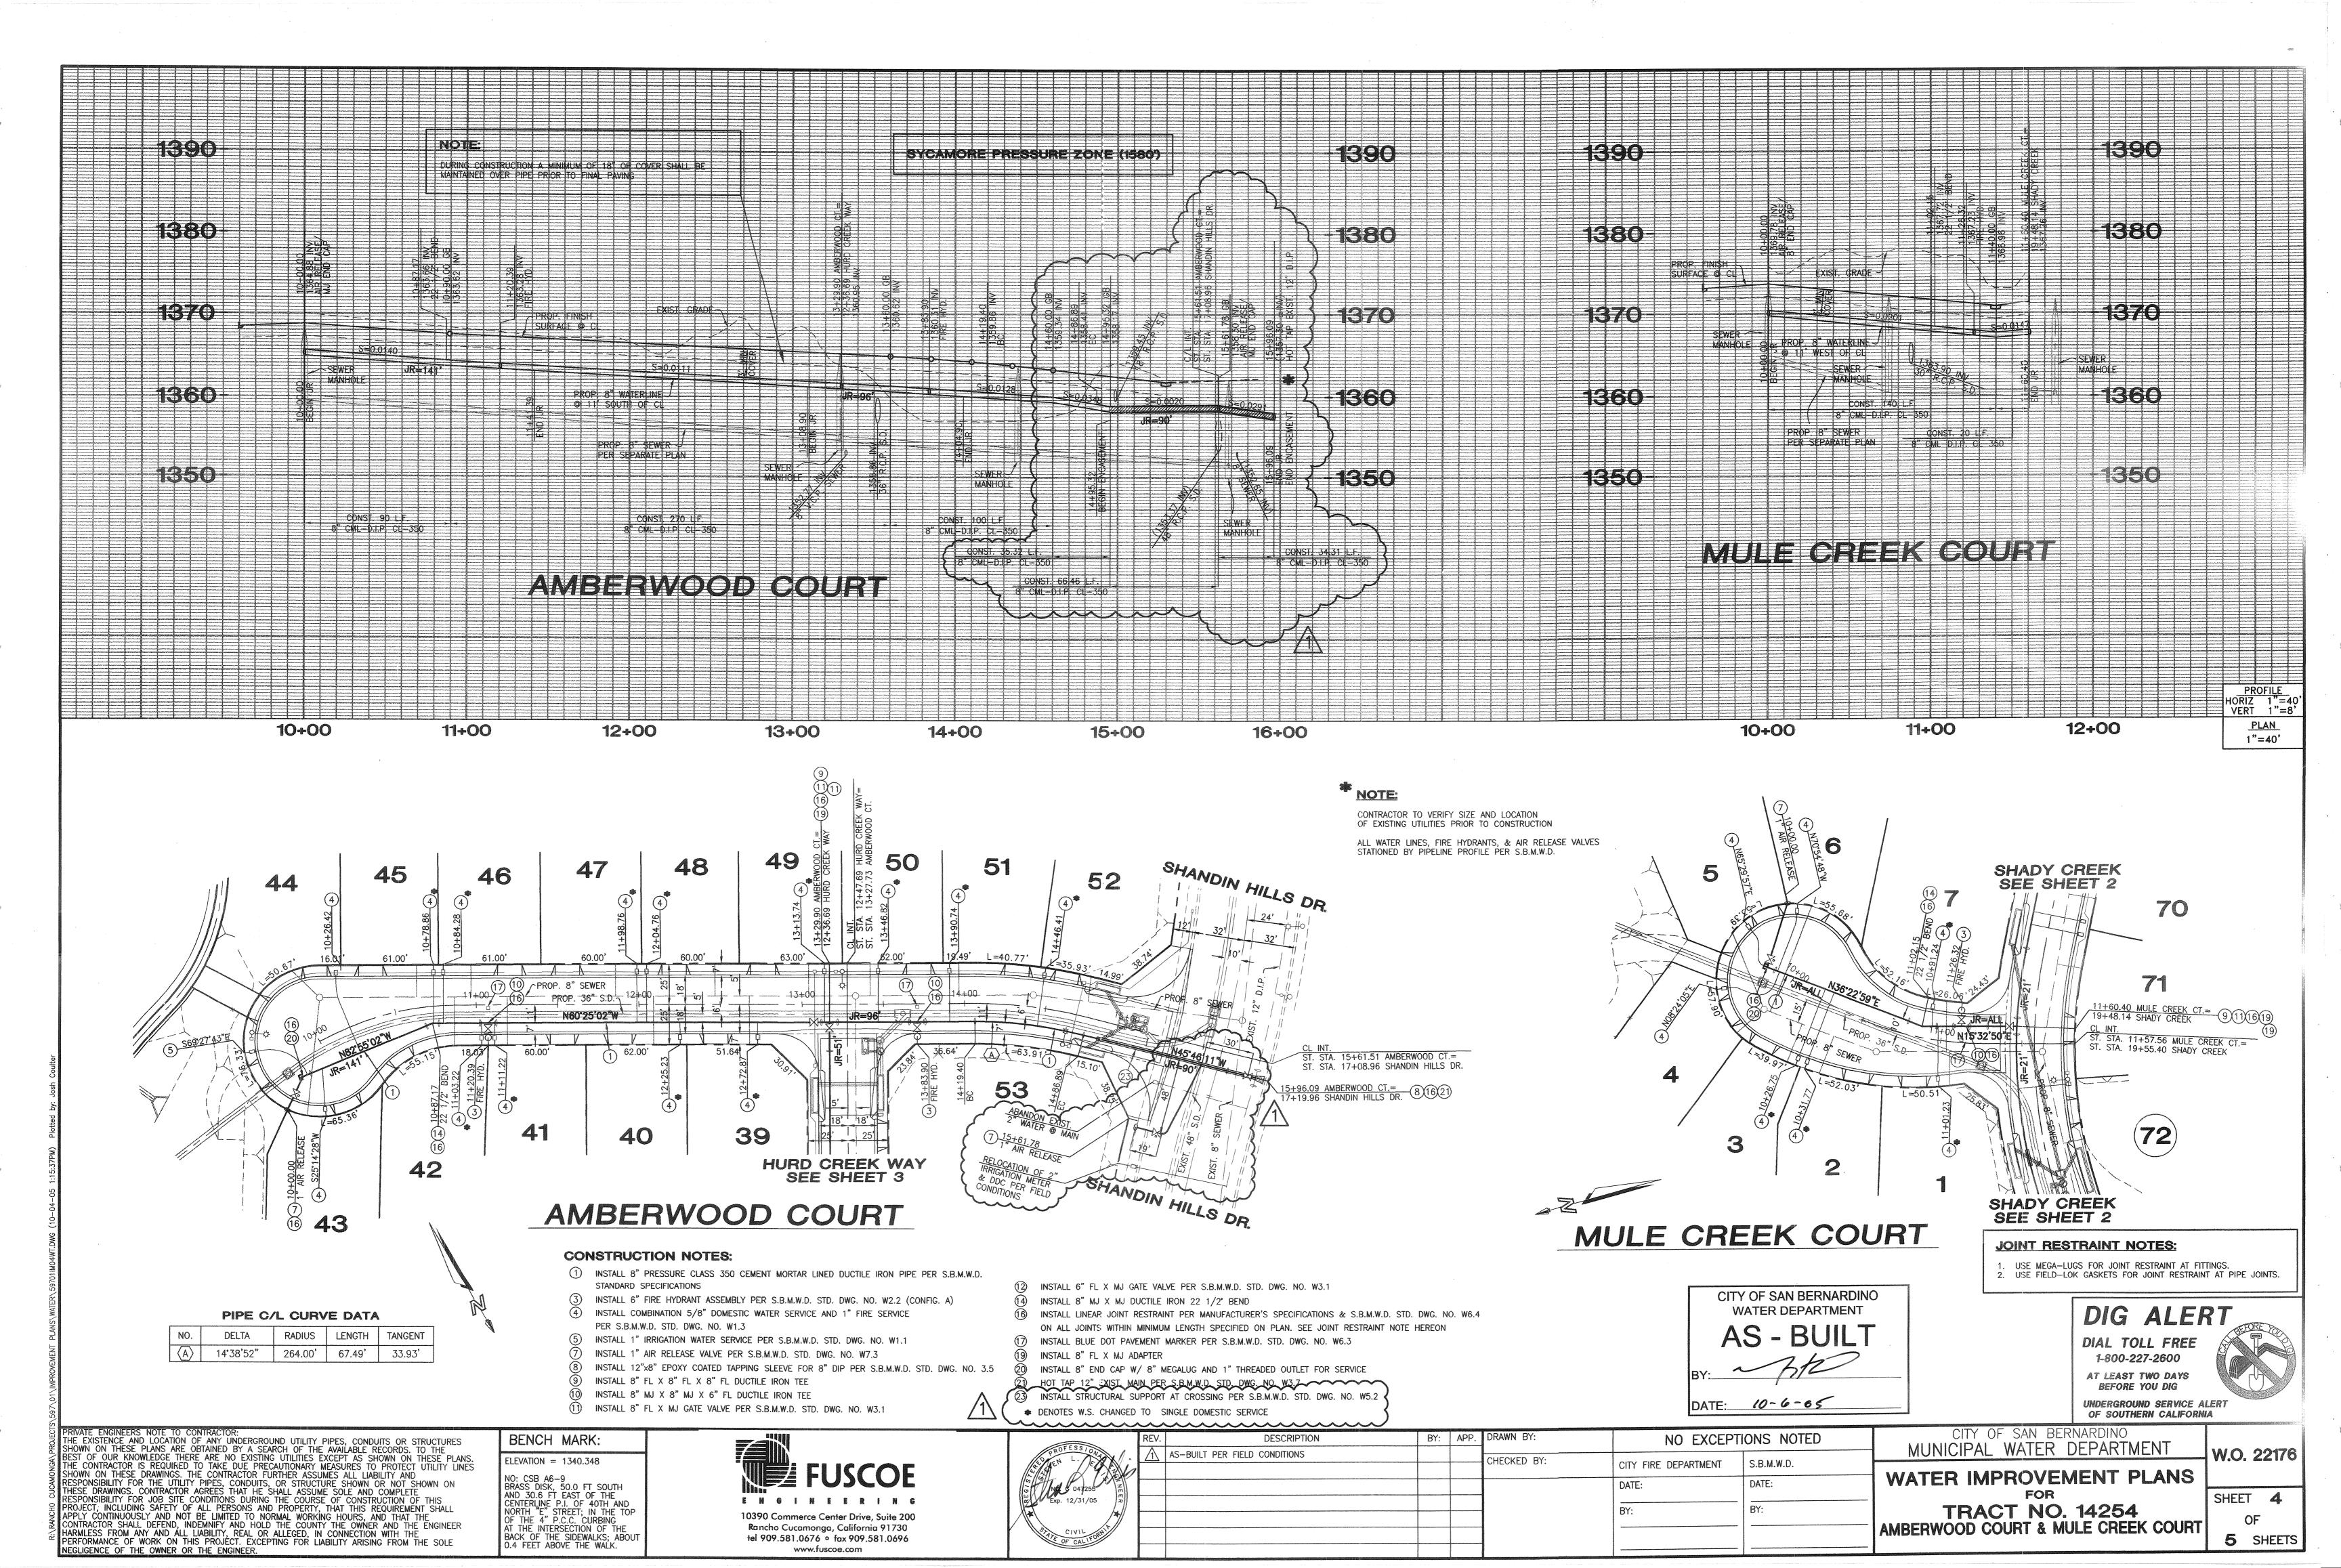

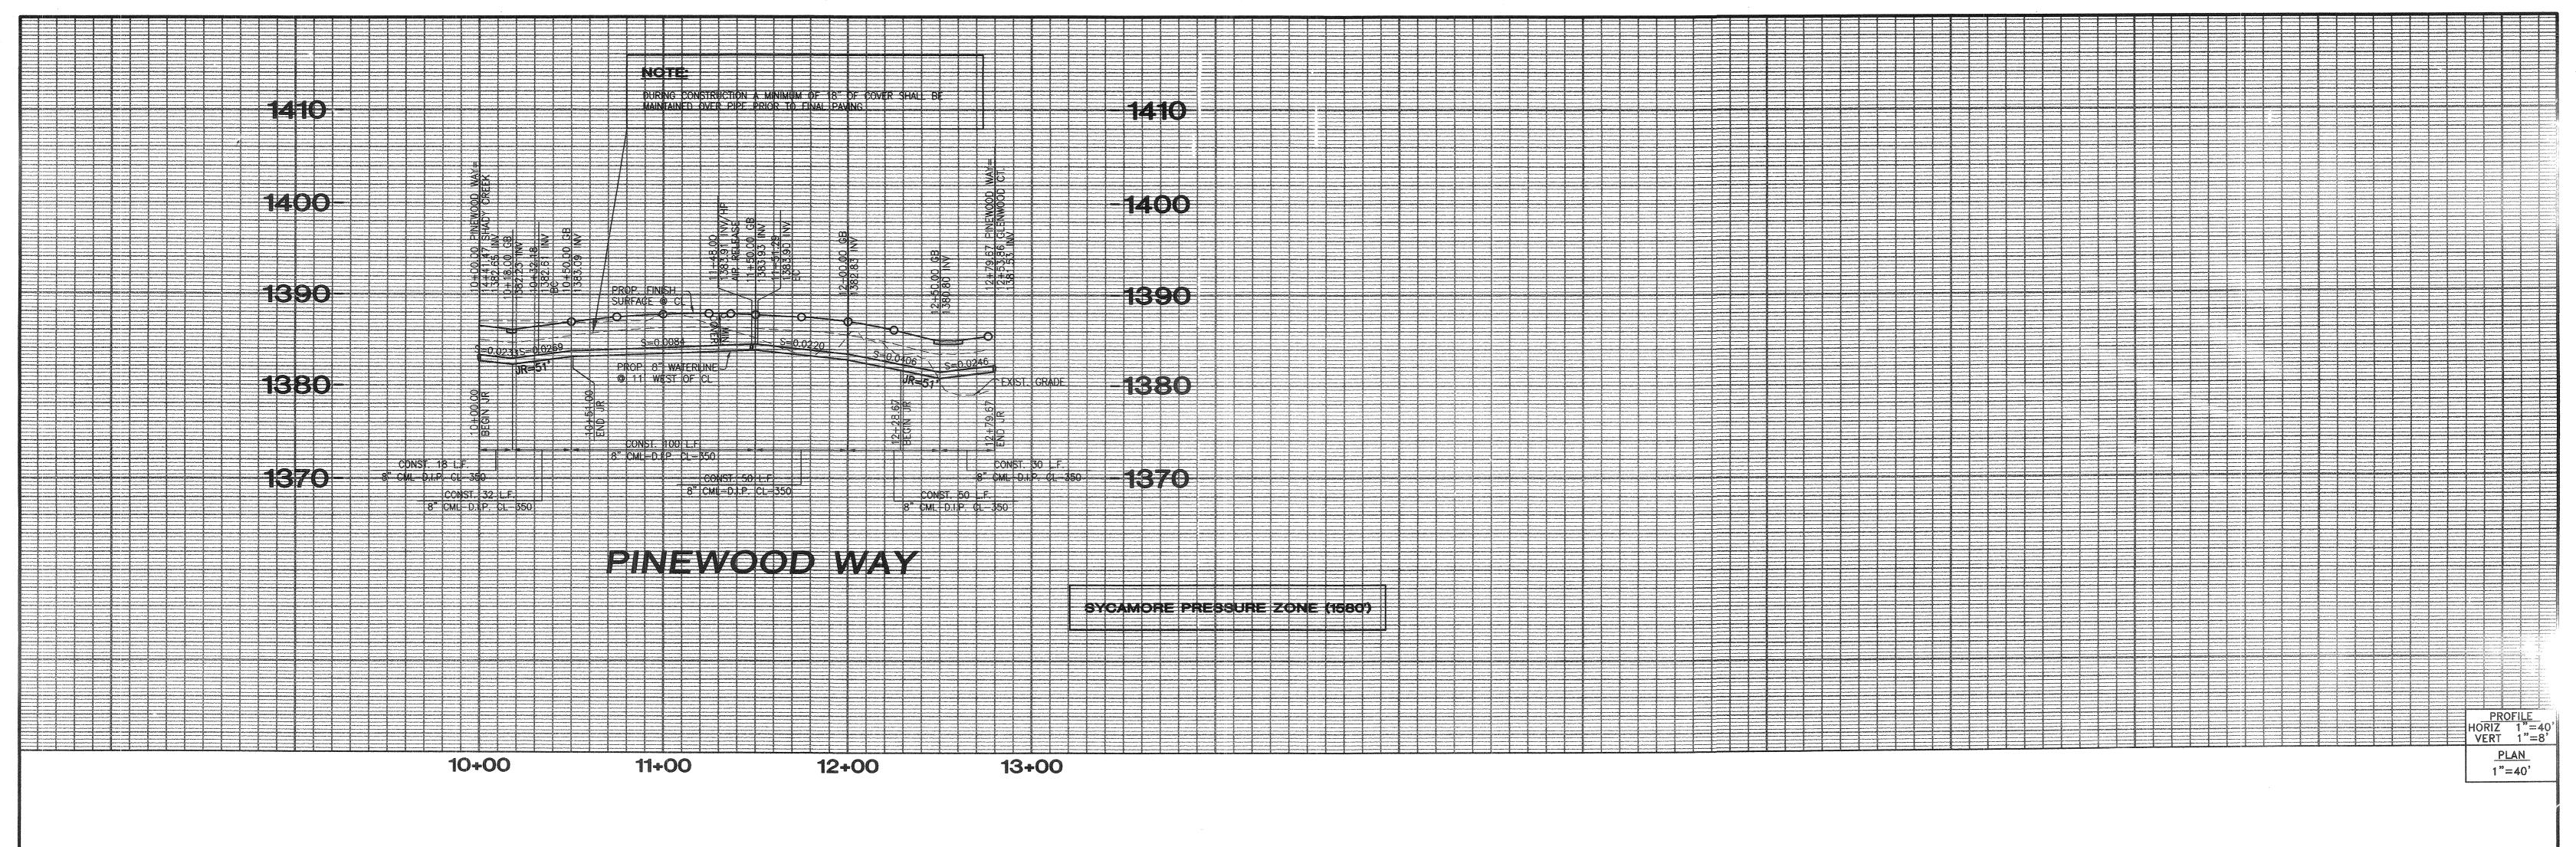

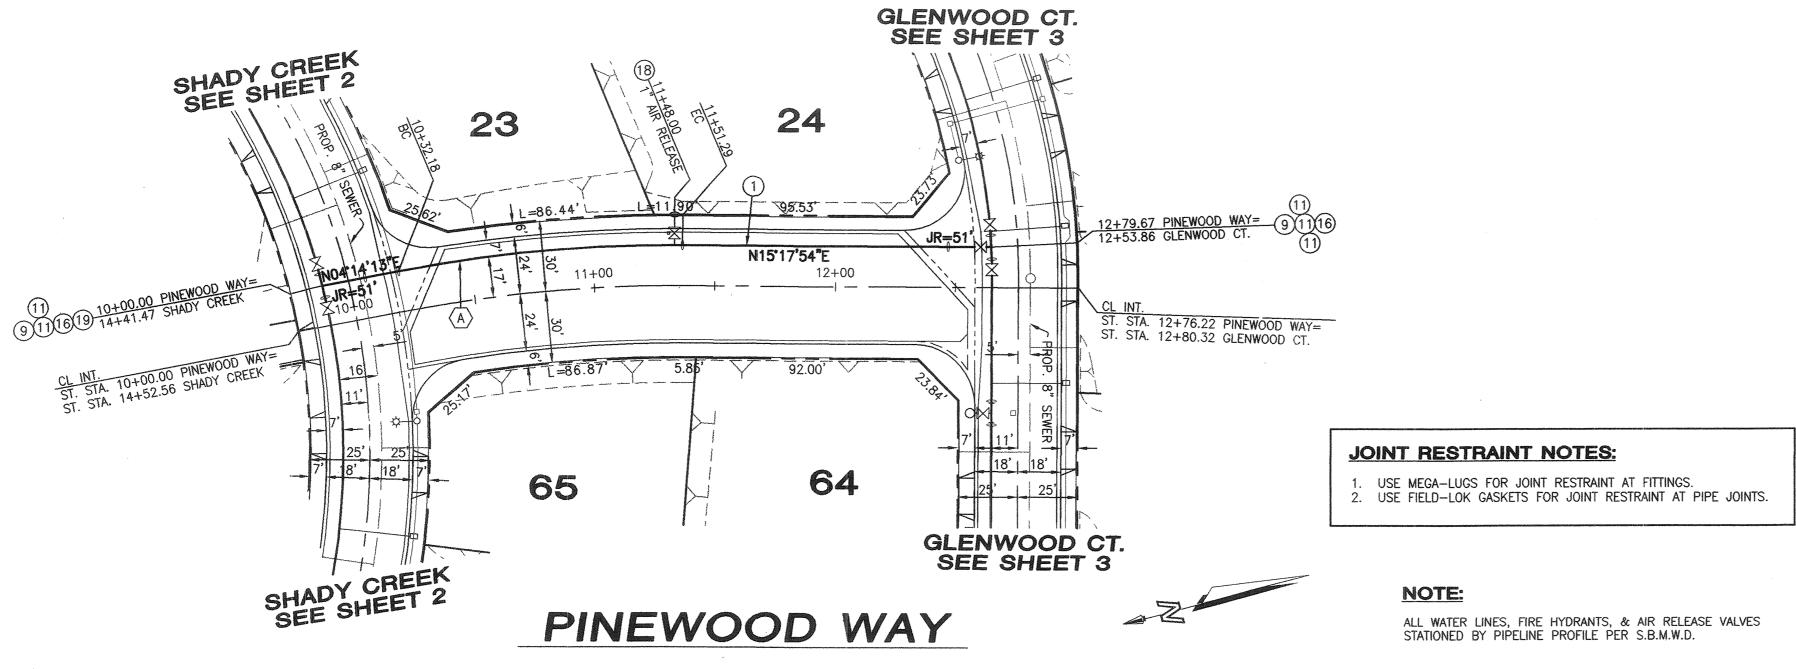


## PIPE C/L CURVE DATA

NO.	DELTA	RADIUS	LENGTH	TANGENT
$\langle A \rangle$	11°03'41"	617.00'	119.12'	59.74'

## **CONSTRUCTION NOTES:**

- INSTALL 8" PRESSURE CLASS 350 CEMENT MORTAR LINED DUCTILE IRON PIPE PER S.B.M.W.D. STANDARD SPECIFICATIONS
- INSTALL 8" FL X 8" FL X 8" FL DUCTILE IRON TEE
- INSTALL 8" FL X MJ GATE VALVE PER S.B.M.W.D. STD. DWG. NO. W3.1
- INSTALL LINEAR JOINT RESTRAINT PER MANUFACTURER'S SPECIFICATIONS & S.B.M.W.D. STD. DWG. NO. W6.4
- ON ALL JOINTS WITHIN MINIMUM LENGTH SPECIFIED ON PLAN. SEE JOINT RESTRAINT NOTE HEREON
- INSTALL 1" AIR RELEASE VALVE PER S.B.M.W.D. STD. DWG. NO. W7.1 INSTALL 8" FL X MJ ADAPTER

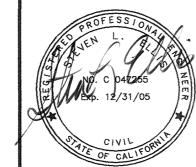

DESCRIPTION	BY:	APP.	DRAWN BY:	
			CHECKED BY:	CITY FIRE
				DATE:
			·	BY:
				<u> </u>

MU	IONS NOTED	PTI
IVIO	S.B.M.W.D.	
WAT	DATE:	
	BY:	

1-800-227-2600 AT LEAST TWO DAYS BEFORE YOU DIG

UNDERGROUND SERVICE ALERT OF SOUTHERN CALIFORNIA CITY OF SAN BERNARDINO
UNICIPAL WATER DEPARTMENT W.O. 22176

DATE: 10-6-05

DIG ALERT

DIAL TOLL FREE

CITY OF SAN BERNARDINO

WATER DEPARTMENT

AS - BUILT

TER IMPROVEMENT PLANS

SHEET 5 5 SHEET

**FUSCOE** ENGINEERING 10390 Commerce Center Drive, Suite 200 Rancho Cucamonga, California 91730 tel 909.581.0676 o fax 909.581.0696 www.fuscoe.com NO EXCEP DEPARTMENT

PRIVATE ENGINEERS NOTE TO CONTRACTOR:
THE EXISTENCE AND LOCATION OF ANY UNDERGROUND UTILITY PIPES, CONDUITS OR STRUCTURES
SHOWN ON THESE PLANS ARE OBTAINED BY A SEARCH OF THE AVAILABLE RECORDS. TO THE
BEST OF OUR KNOWLEDGE THERE ARE NO EXISTING UTILITIES EXCEPT AS SHOWN ON THESE PLANS.
THE CONTRACTOR IS REQUIRED TO TAKE DUE PRECAUTIONARY MEASURES TO PROTECT UTILITY LINES
SHOWN ON THESE DRAWINGS. THE CONTRACTOR FURTHER ASSUMES ALL LIABILITY AND
RESPONSIBILITY FOR THE UTILITY PIPES, CONDUITS, OR STRUCTURE SHOWN OR NOT SHOWN ON
THESE DRAWINGS. CONTRACTOR AGREES THAT HE SHALL ASSUME SOLE AND COMPLETE
RESPONSIBILITY FOR JOB SITE CONDITIONS DURING THE COURSE OF CONSTRUCTION OF THIS
PROJECT, INCLUDING SAFETY OF ALL PERSONS AND PROPERTY, THAT THIS REQUIREMENT SHALL
APPLY CONTINUOUSLY AND NOT BE LIMITED TO NORMAL WORKING HOURS, AND THAT THE
CONTRACTOR SHALL DEFEND, INDEMNIFY AND HOLD THE COUNTY THE OWNER AND THE ENGINEER
HARMLESS FROM ANY AND ALL LIABILITY, REAL OR ALLEGED, IN CONNECTION WITH THE
PERFORMANCE OF WORK ON THIS PROJECT. EXCEPTING FOR LIABILITY ARISING FROM THE SOLE
NEGLIGENCE OF THE OWNER OR THE ENGINEER.

ELEVATION = 1340.348NO: CSB A6-9
BRASS DISK, 50.0 FT SOUTH
AND 30.6 FT EAST OF THE
CENTERLINE P.I. OF 40TH AND
NORTH "E" STREET; IN THE TOP
OF THE 4" P.C.C. CURBING
AT THE INTERSECTION OF THE
BACK OF THE SIDEWALKS; ABOUT
0.4 FEET ABOVE THE WALK.

BENCH MARK:

TRACT NO. 14254 PINEWOOD WAY